

> Follow Paul Kruger St to Mansfield/R101  
1 min (700 m)

Head north on Paul Kruger St toward Green St  
500 m

Keep right to stay on Paul Kruger St  
180 m

Slight left onto Mansfield/R101  
Continue to follow R101  
1 min (1.0 km)

>Follow M1 to R566  
3 min (3.3 km)

Continue onto M1  
800 m

Turn left to stay on M1  
2.5 km

Turn left onto R566  
8 min (9.2 km)

>Continue on M20. Drive to Gaigher St  
5 min (3.9 km)

Use the right 2 lanes to turn right onto Doreen Ave/M20  
Continue to follow M20  
2.5 km

Turn left onto Kitshof St  
700 m

Turn left onto Gaigher St

>Continue on N1 . Take Ben Schoeman Fwy/Pretoria Main Rd and M1 to N12  
51 min (79.7 km)

Merge onto N1/N4  
Continue to follow N1  
Toll road  
22.4 km

Use the left 3 lanes to take exit 124A to  
merge onto Ben Schoeman Fwy/Pretoria Main Rd/N1 toward Midrand/Johannesburg  
Toll road  
20.7 km

Continue straight onto M1  
21.5 km

Use the right 2 lanes to turn slightly right onto De Villiers Graaff Motorway/M1  
6.7 km

Use the middle 2 lanes to continue on M1  
800 m

Use the left 2 lanes to take exit 391 to merge onto N12 Southern Bypass/N12 toward M68/Soweto/Kimberley/N1/Bloemfontein  
Toll road  
2.3 km

Use the left 2 lanes to take exit 67 for M68 toward Soweto  
Toll road  
450 m

Keep right, follow signs for N12/Bloemfontein/Kimberley  
Toll road  
1.1 km

Continue onto N1/N12  
Toll road  
3.8 km

>Continue on N12 to your destination in Kokosi, Fochville  
51 min (69.7 km)

Keep left at the fork to continue on N12, follow signs for Potchefstroom/Kimberley  
61.5 km

Turn left  
6.0 km

Turn right onto Tshwagong Ave  
1.3 km

Turn right  
650 m

Turn left toward Moeketsi St  
35 m

Turn left onto Moeketsi St  
140 m

Turn left toward C Ramaphosa St  
56 m

Turn right onto C Ramaphosa St  
42 m

Turn right  
40 m  
Kokosi

**SITE DIRECTIONS  
FROM  
GOHVAN TO  
NISSAN ROSSLYN  
R566: 22.8km - 27MINS**

**S 25° 37' 20.53"  
E 28° 05' 16.40"**

**VODACOM - SITE NAME & BASE STATION NUMBER**

**NISSAN ROSSLYN  
BS: 0136022  
(As-Built)**

**LOCALITY PLAN**

**COORDINATES**

LATS : 25° 37' 20.53" S  
LONGS: 28° 05' 16.94" E  
HASL: 1262M  
REGION: NORTHERN GAUTENG

**VODACOM - PROPERTY DESCRIPTION**

78 GAIGHER STREET  
ROSSLYN EXTENSION 1  
PRETORIA  
GAUTENG



**PROJECT DESCRIPTION**

INSTALLATION OF A NEW 35m HIGH LATTICE  
AND A VODACOM ARP 1DOOR MICRO  
CONTAINER

Rev	Date	Reason for Revision
01		
02		
03		
04		



**GOHVAN CONSTRUCTION (PTY)Ltd**  
Reg. no.2006/009765/07  
VAT Reg. no. 4110220265  
P.O. Box 32326 Waverley 0135  
Tel: (012) 332 5580 Fax: 0966 842 726  
E-Mail: mbe@gohvan.co.za

**PROJECT NR : 18378**

**DATE :20/03/2020**

**SCALE : Not to scale**


**DRAWN BY :  
ROSHUMA MAKHWANYA**



**REPRESENTATIVE  
BENNIE DE WET  
082 990 9435**

**PAGE 1 OF 8**



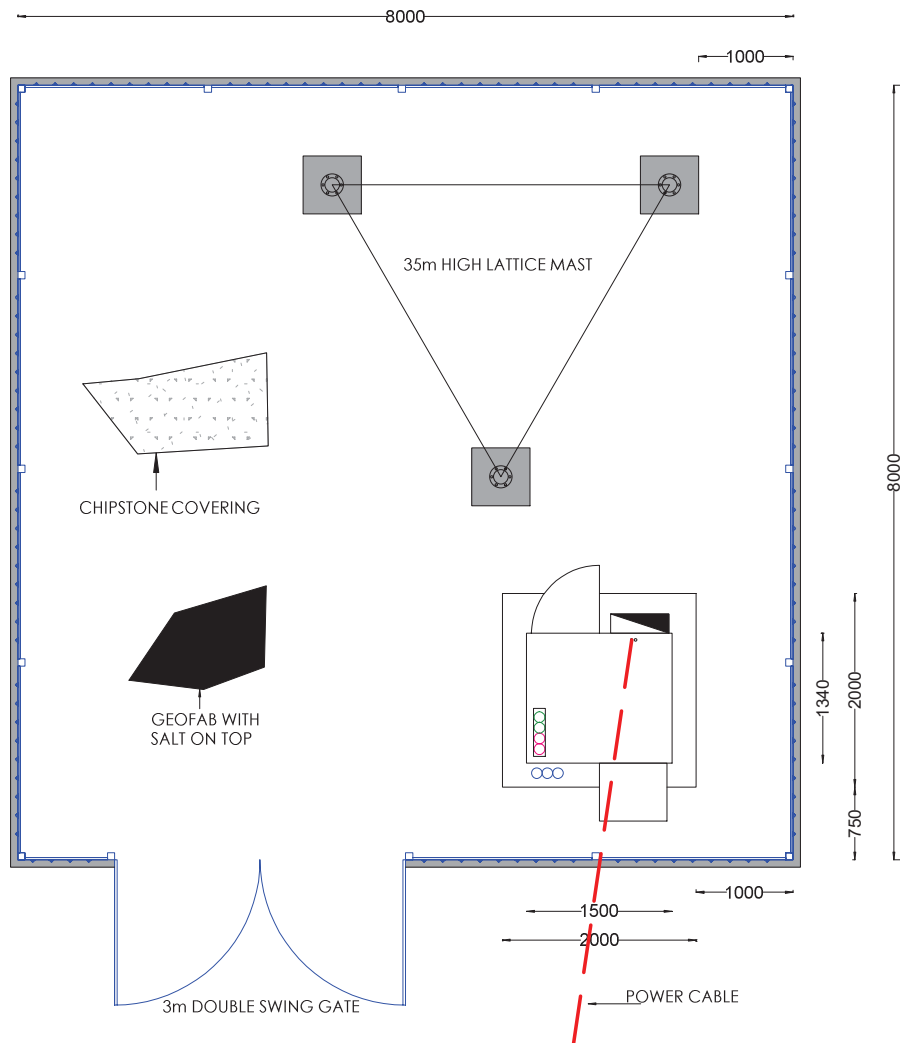

## NISSAN ROSSLYN NOTES

**-MAST TYPE:** 35m HIGH LATTICE MAST

**-ANTENNA SPECIFICATIONS:** 3X KATHREIN 80020892 ANTENNAS

**-FENCE:** 2m HIGH ANGLE IRON FENCE

**-BTS SIZE:** 8m x 8m WITH CHIPSTONE COVERING

**-VODACOM CONTAINER:** ARP 1DOOR MICRO CONTAINER 1.34 X 1.5 X 2.2M

**-CONTAINER COLOUR:** WHITE

**-POWER:** POWER CABLE RUNNING 600mm UNDERGROUND SECURED SAFELY WITH CONCRETE AND CONNECTING TO PROPERTY OWNER DB

**-LOCKS:** 1x VCL LOCKS

### VODACOM - SITE NAME & BASE STATION NUMBER

NISSAN ROSSLYN  
BS: 0136022  
(As-Built)

### BTS LAYOUT

COORDINATES  
LATS : 25° 37' 20.53" S  
LONGS: 28° 05' 16.94" E  
HASL: 1262M  
REGION: NORTHERN GAUTENG

### VODACOM - PROPERTY DESCRIPTION

78 GAIGHER STREET  
ROSSLYN EXTENSION 1  
PRETORIA  
GAUTENG



### PROJECT DESCRIPTION

INSTALLATION OF A NEW 35m HIGH LATTICE  
AND A VODACOM ARP 1DOOR MICRO  
CONTAINER

Rev	Date	Reason for Revision
01		
02		
03		
04		



GOHVAN CONSTRUCTION (PTY)Ltd  
Reg. no.2006/009765/07  
VAT Reg. no. 4110226285  
P.O. Box 32326 Waverley 0135  
Tel: (012) 352 5500 Fax: 0866 842 726  
E-Mail: info@gohvan.co.za

PROJECT NR : 18378

DATE :20/03/2020


SCALE : Not to scale

DRAWN BY :  
ROSHUMA MAKHWANYA



REPRESENTATIVE  
BENNIE DE WET  
082 990 9435

PAGE 3 OF 8

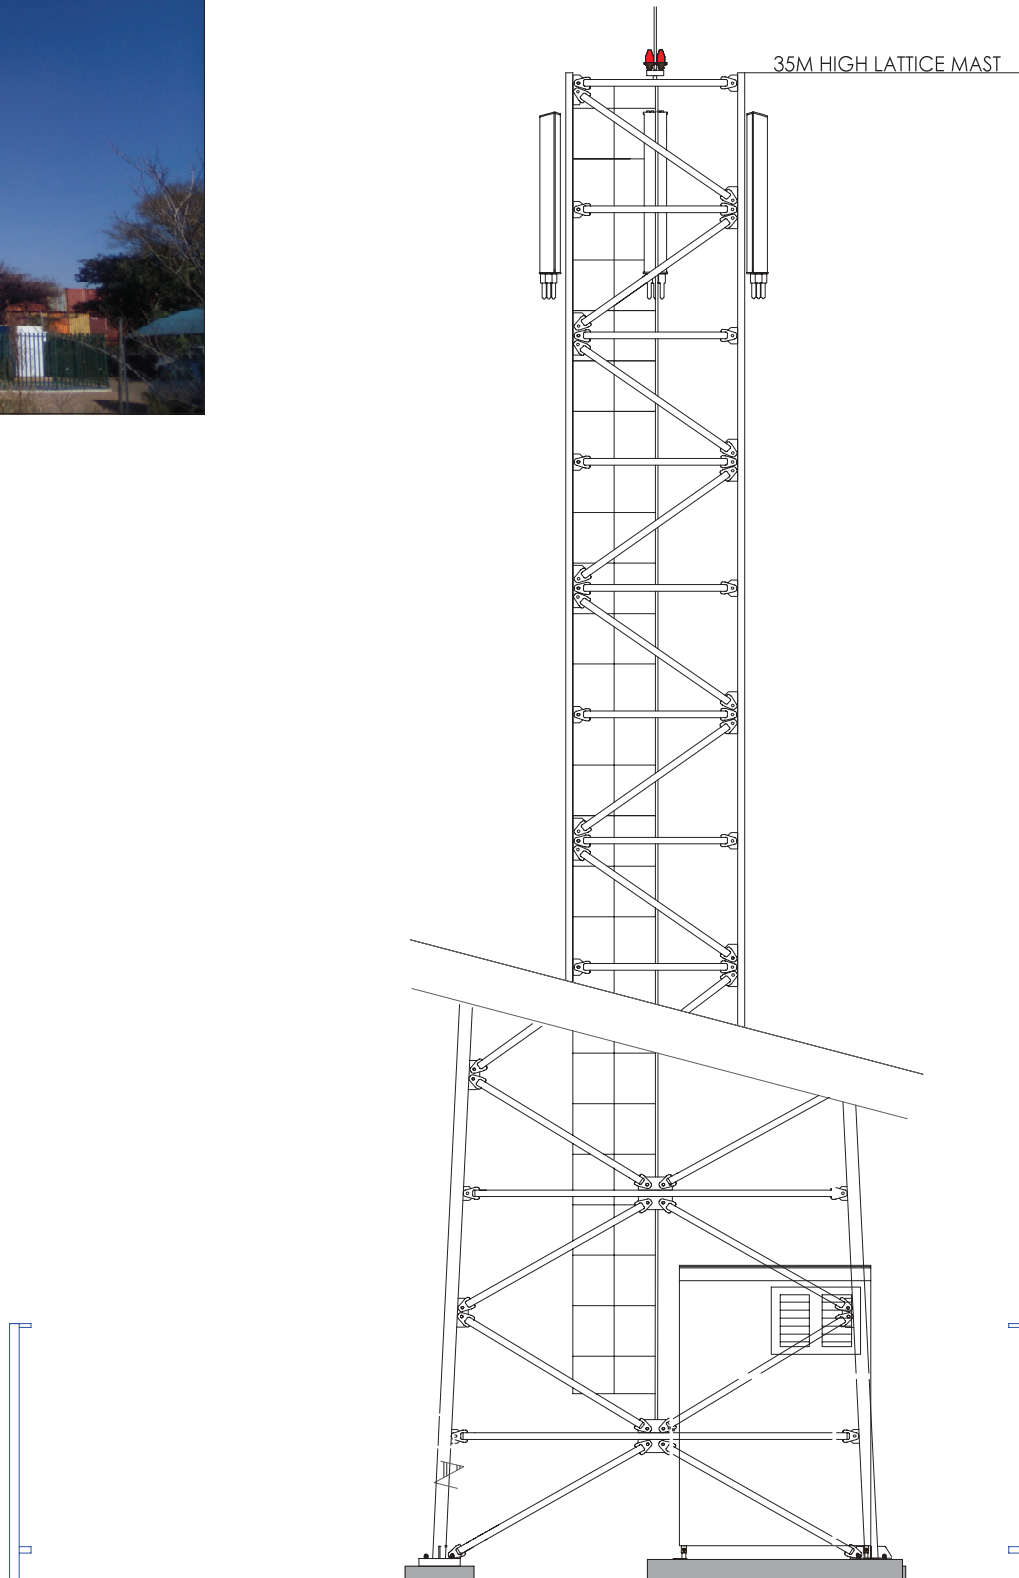

**VODACOM - SITE NAME & BASE STATION NUMBER**

**NISSAN ROSSLYN**  
BS: 0136022  
(As-Built)

**ELEVATION**

**COORDINATES**  
LATS : 25° 37' 20.53" S  
LONGS: 28° 05' 16.94" E  
HASL: 1262M  
REGION: NORTHERN GAUTENG

**VODACOM - PROPERTY DESCRIPTION**

76 GAIGHER STREET  
ROSSLYN EXTENSION 1  
PRETORIA  
GAUTENG



**PROJECT DESCRIPTION**

INSTALLATION OF A NEW 35m HIGH LATTICE  
AND A VODACOM ARP 1DOOR MICRO  
CONTAINER

Rev	Date	Reason for Revision
01		
02		
03		
04		



**GOHVAN CONSTRUCTION (PTY) Ltd**  
Reg. no. 2006/009765/07  
VAT Reg. no. 4110229285  
P.O. Box 32526 Waverley 0135  
Tel: (012) 332 5560 Fax: 0866 842 726  
E-Mail: info@gothvan.co.za

**PROJECT NR : 18378**


DATE :20/03/2020

SCALE : Not to scale

DRAWN BY :  
**ROSHUMA MAKHWANYA**



REPRESENTATIVE  
BENNIE DE WET  
082 990 9435

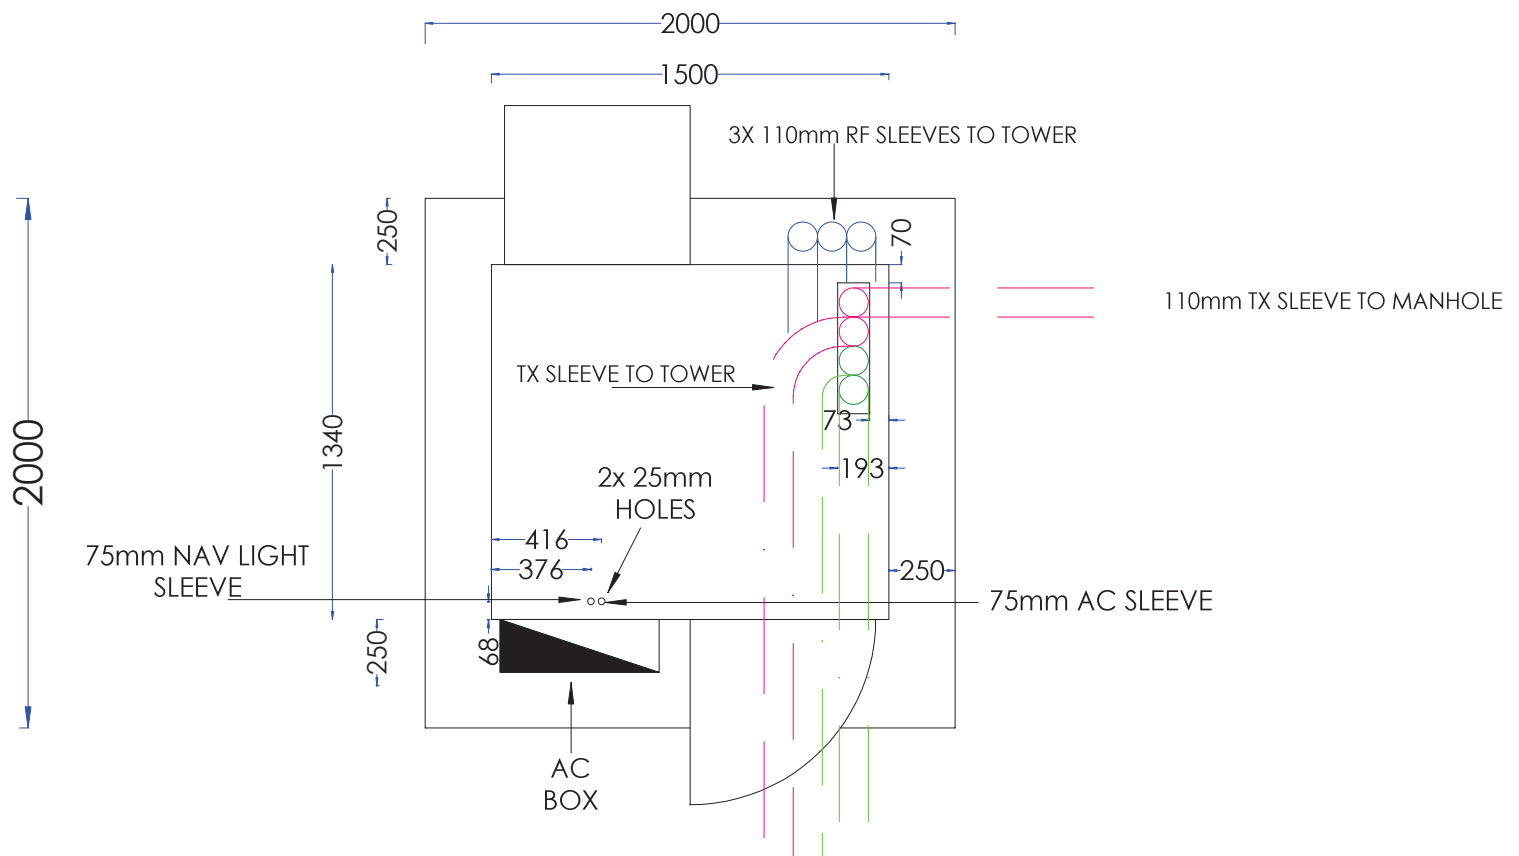

**VODACOM - SITE NAME & BASE STATION NUMBER**

**NISSAN ROSSLYN**  
**BS: 0136022**  
**(As-Built)**

**CONTAINER LAYOUT**

**COORDINATES**  
 LATS : 25° 37' 20.53" S  
 LONGS: 28° 05' 16.94" E  
 HASL: 1262M  
 REGION: NORTHERN GAUTENG

**VODACOM - PROPERTY DESCRIPTION**

78 GAIGHER STREET  
 ROSSLYN EXTENSION 1  
 PRETORIA  
 GAUTENG



**PROJECT DESCRIPTION**

INSTALLATION OF A NEW 35m HIGH LATTICE  
 AND A VODACOM ARP 1DOOR MICRO  
 CONTAINER

Rev	Date	Reason for Revision
01		
02		
03		
04		



**GOHVAN CONSTRUCTION (PTY)Ltd**  
 Reg. no.2006/009765/07  
 VAT Reg. no. 4110229285  
 Po Box 30206 Waverley 0135  
 Tel: (012) 332 5590 Fax: 0866 842 726  
 E-Mail: [info@gothvan.co.za](mailto:info@gothvan.co.za)

**PROJECT NR : 18378**





DATE :20/03/2020

SCALE : Not to scale

DRAWN BY:  
**ROSHUMA MAKHWANYA**



REPRESENTATIVE  
 BENNIE DE WET  
 082 990 9435

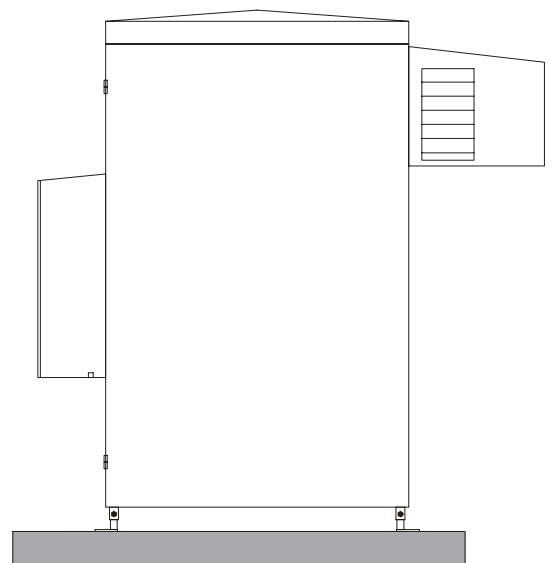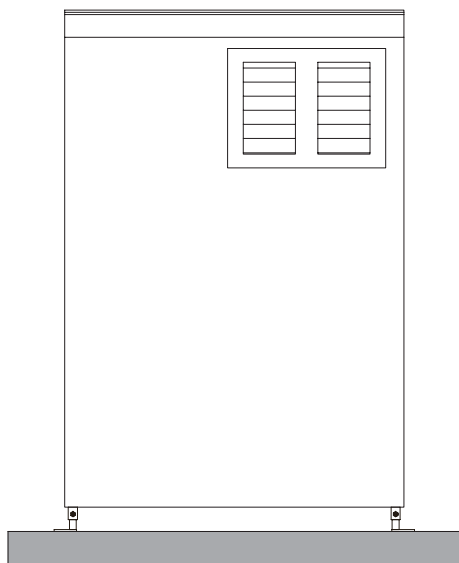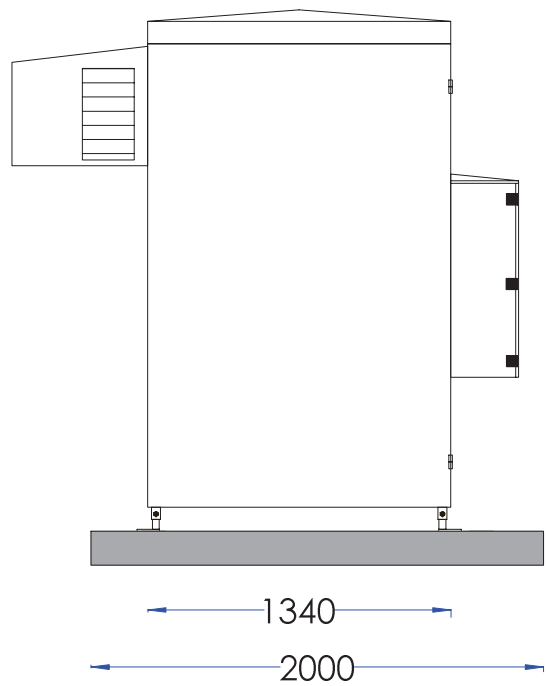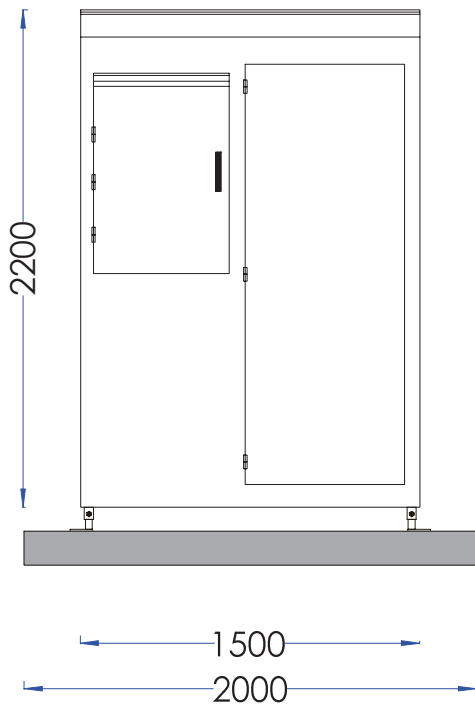

#### VODACOM - SITE NAME & BASE STATION NUMBER

**NISSAN ROSSLYN**  
BS: 0136022  
(As-Built)

#### CONTAINER DETAIL

**COORDINATES**  
LATS : 25° 37' 20.53" S  
LONGS: 28° 05' 16.94" E  
HASL: 1262M  
REGION: NORTHERN GAUTENG

#### VODACOM - PROPERTY DESCRIPTION

78 GAIGHER STREET  
ROSSLYN EXTENSION 1  
PRETORIA  
GAUTENG



#### PROJECT DESCRIPTION

INSTALLATION OF A NEW 35m HIGH LATTICE  
AND A VODACOM ARP 1DOOR MICRO  
CONTAINER

Rev	Date	Reason for Revision
01		
02		
03		
04		



**GOHVAN CONSTRUCTION (PTY)Ltd**  
Reg. no. 2006/009765/07  
VAT Reg. no. 4110229285  
P.O. Box 32526 Waverley 0135  
Tel: (012) 332 5560 Fax: 0866 842 726  
E-Mail: [info@gohvan.co.za](mailto:info@gohvan.co.za)

PROJECT NR : 18378

DATE :20/03/2020

SCALE : Not to scale

DRAWN BY :  
ROSHUMA MAKHWANYA



REPRESENTATIVE  
BENNIE DE WET  
082 990 9435

**PAGE 6 OF 8**





VODACOM - SITE NAME & BASE STATION NUMBER

**NISSAN ROSSLYN**  
BS: 0136022  
(As-Built)

**PHOTOS**

COORDINATES  
LATS : 25° 37' 20.53" S  
LONGS: 28° 05' 16.94" E  
HASL: 1262M  
REGION: NORTHERN GAUTENG

VODACOM - PROPERTY DESCRIPTION

78 GACHER STREET  
ROSSLYN EXTENSION 1  
PRETORIA  
GAUTENG



PROJECT DESCRIPTION

INSTALLATION OF A NEW 35m HIGH LATTICE  
AND A VODACOM ARP 1DOOR MICRO  
CONTAINER

Rev	Date	Reason for Revision
01		
02		
03		
04		



**GOHVAN CONSTRUCTION (PTY) Ltd**  
Reg. no. 2006/0976507  
VAT Reg. no. 4110229285  
Po Box 32326 Waverley 0135  
Tel: (012) 332 5580 Fax: 0866 842 726  
E-Mail: [info@gohvan.co.za](mailto:info@gohvan.co.za)

PROJECT NR : 18378

DATE :20/03/2020

SCALE : Not to scale

DRAWN BY :  
ROSHUMA MAKHWANYA



REPRESENTATIVE  
BENNIE DE WET  
082 990 9435

**PAGE 7 OF 8**





#### VODACOM - SITE NAME & BASE STATION NUMBER

**NISSAN ROSSLYN**  
BS: 0136022  
(As-Built)

#### SITE LAYOUT

##### COORDINATES

LATS : 25° 37' 20.53" S  
LONGS: 28° 05' 16.94" E  
HASL: 1262M  
REGION: NORTHERN GAUTENG

#### VODACOM - PROPERTY DESCRIPTION

78 GAUCHER STREET  
ROSSLYN EXTENSION 1  
PRETORIA  
GAUTENG



#### PROJECT DESCRIPTION

INSTALLATION OF A NEW 35m HIGH LATTICE  
AND A VODACOM ARP 1DOOR MICRO  
CONTAINER

Rev	Date	Reason for Revision
01		
02		
03		
04		



**GOHVAN CONSTRUCTION (PTY) Ltd**  
Reg. no.2006/009765/07  
VAT Reg. no. 4110225065  
P.O. Box 32326 Waverley 0135  
Tel: (012) 332 5580 Fax: 0866 842 726  
E-Mail: [info@gohvan.co.za](mailto:info@gohvan.co.za)

PROJECT NR : 18378

DATE :20/03/2020

SCALE : Not to scale

DRAWN BY :  
ROSHUMA MAKHWANYA



REPRESENTATIVE  
BENNIE DE WET  
082 990 9435

**PAGE 8 OF 8**